


*NOTE: BALLOON REFERENCES ARE FOR BILL OF MATERIAL ON DRAWING 83E206-3

07/02/2018 D. ROLING	06/18/2018 D. ROLING	02/19/2018 D. ROLING	01/30/2018 D. ROLING	DATE BY	ALTORFER POWER SYSTEMS 6315 W. FAUBER RD. PHONE (309) 697-1234 BARTONVILLE, IL 61807 FAX (309) 282-7546				
REVISED PER BUILD	REMOVED BOM FROM DRAWING ADD TO DRAWING 83E206-03	REVISED AS-BUILT	AS-BUILT	CHANGE NOTICE					THIS DOCUMENT CONTAINS PROPRIETARY INFORMATION OF ALTORFER, INC. WITHOUT THE WRITTEN PERMISSION OF ALTORFER, INC., ANY COPYING OR OTHER USE EXCEPT THAT FOR WHICH IT WAS INTENDED IS PROHIBITED.
ALL DIMENSIONS IN INCHES UNLESS OTHERWISE SPECIFIED					FILE	PROJECT REFERENCE			
TOLERANCES: X.X ± 0.100 X.XX ± 0.060 X.XXX ± 0.005					DF/83E	3516B REMAN POWER MODULE			
THIRD ANGLE PROJECTION					SCALE/SHEET SIZE	DRAWN BY			
ANGULAR ± 1°					1=1/B	D. ROLING			
TITLE					SHEET	DATE	PROTO	PET	PROD
INTERCONNECT HARNESS - ENGINE TO P7/DOGHOUSE					1 OF 2	07/24/2017	X	X	X
DRAWING NUMBER								83E201A-04	

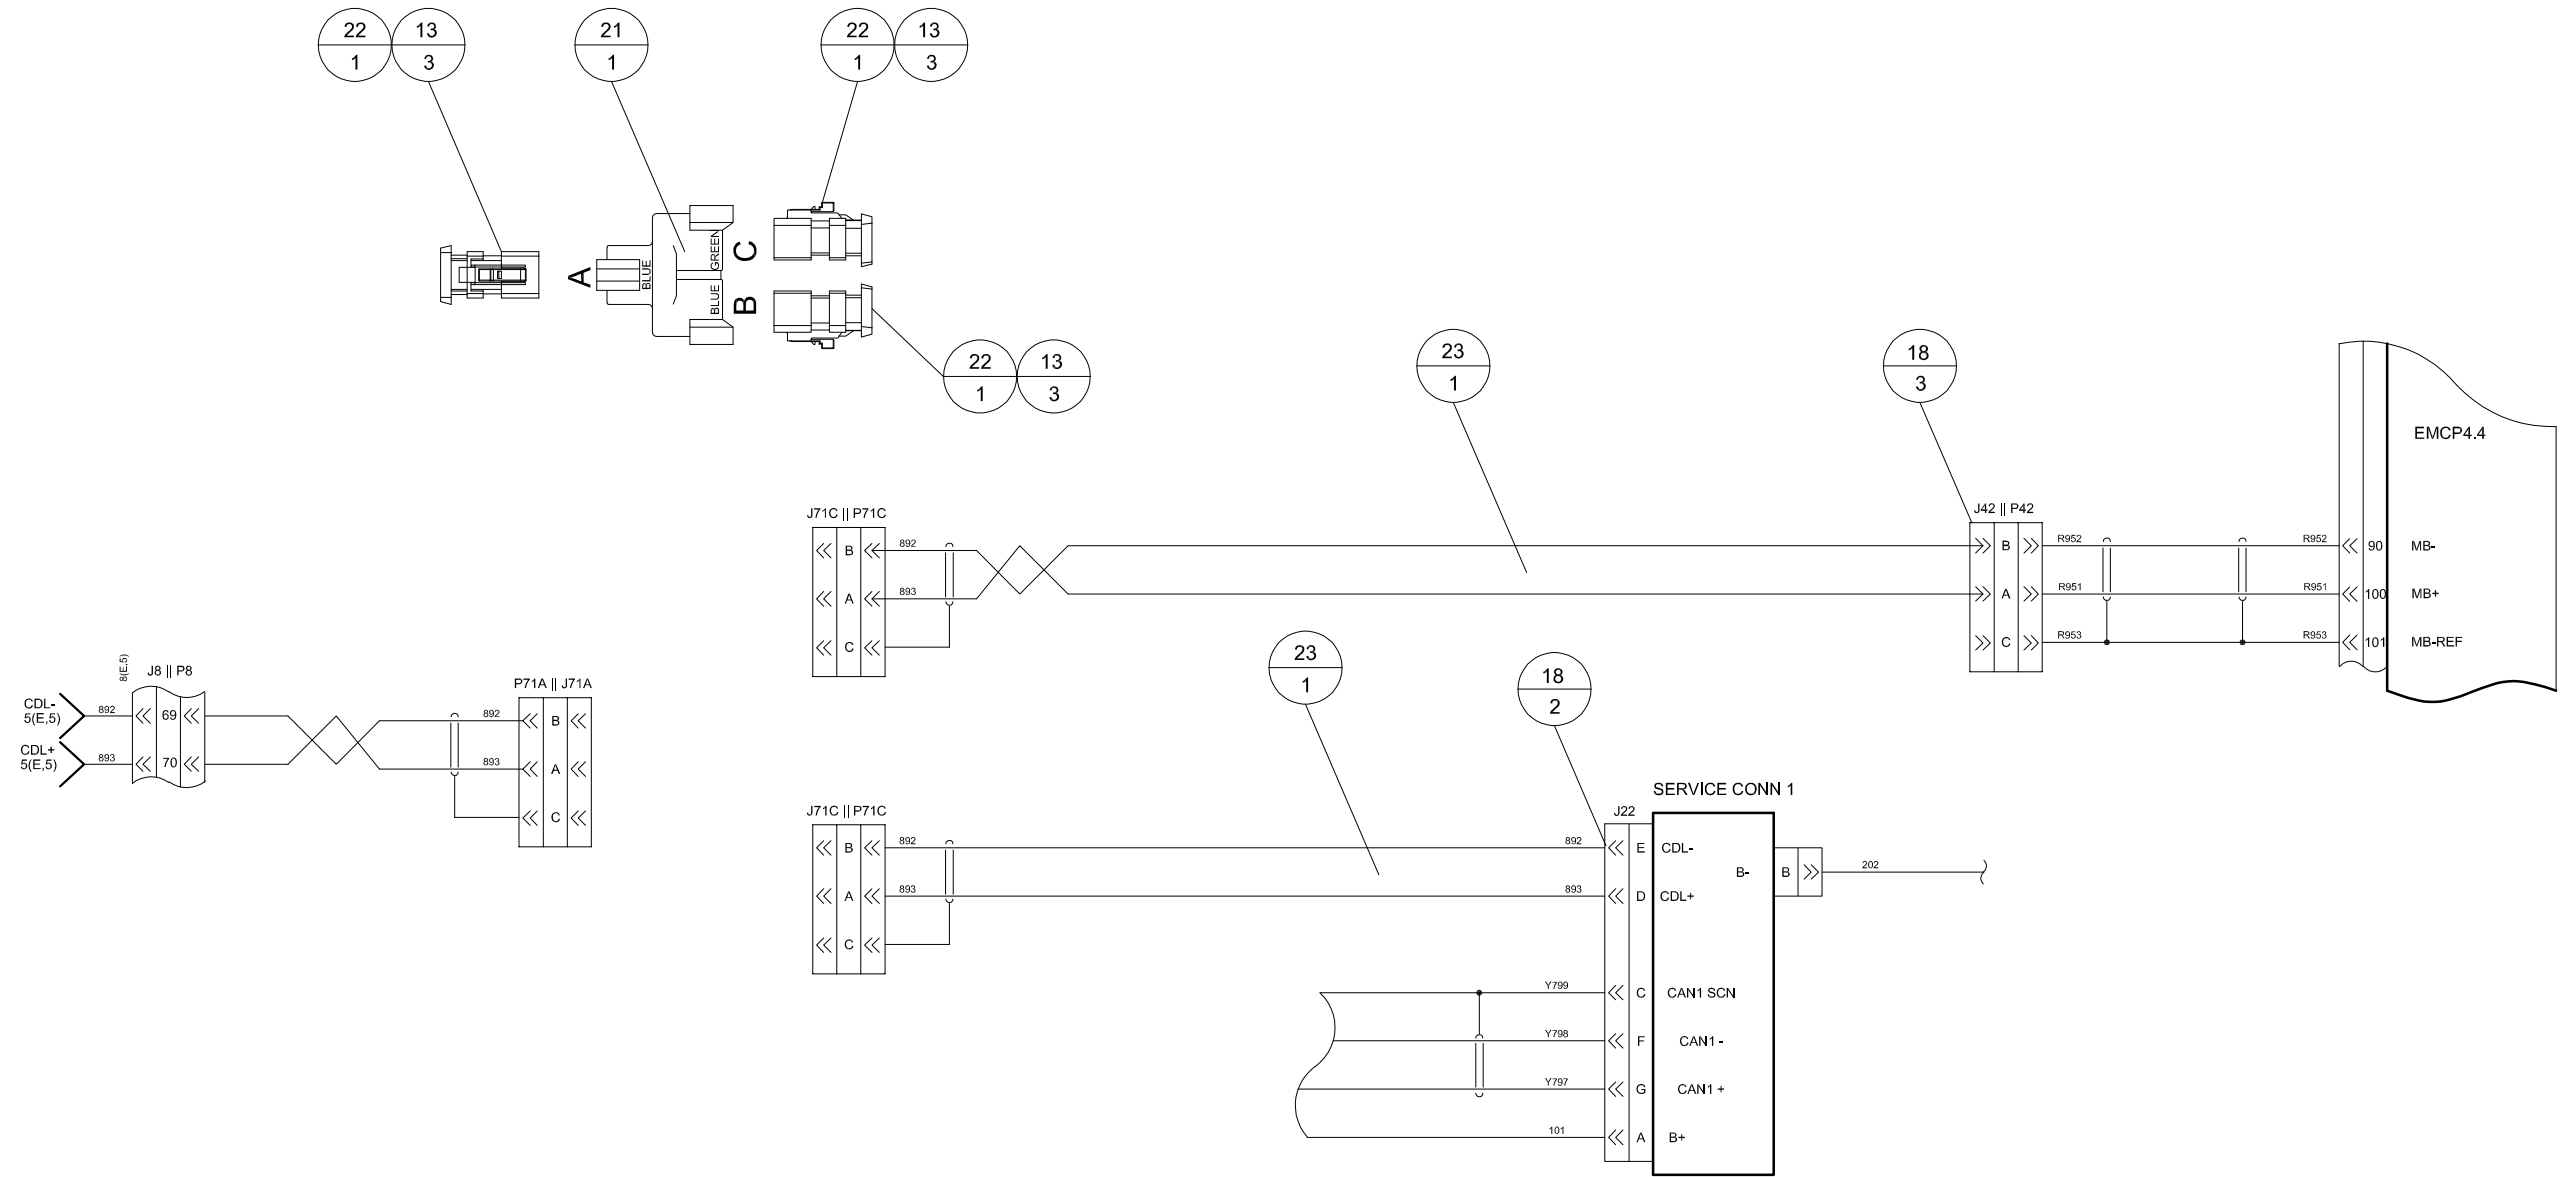

*NOTE: BALLOON REFERENCES ARE FOR BILL OF MATERIAL ON DRAWING 83E206-3

07/02/2018 D. ROLING	06/18/2018 D. ROLING	06/19/2018 D. ROLING	07/02/2018 D. ROLING	DATE BY	ALTORFER POWER SYSTEMS 6315 W. FAUBER RD. PHONE (309) 697-1234 BARTONVILLE, IL 61807 FAX (309) 282-7546						
REMOVED FROM DRAWING ADD TO DRAWING 83E206-03	REMOVED FROM DRAWING ADD TO DRAWING 83E206-03	REMOVED FROM DRAWING ADD TO DRAWING 83E206-03	REMOVED FROM DRAWING ADD TO DRAWING 83E206-03	NO					THIS DOCUMENT CONTAINS PROPRIETARY INFORMATION OF ALTORFER, INC. WITHOUT THE WRITTEN PERMISSION OF ALTORFER, INC., ANY COPYING OR OTHER USE EXCEPT THAT FOR WHICH IT WAS INTENDED IS PROHIBITED		
REVISIONS	REVISIONS	REVISIONS	REVISIONS	NO	ALL DIMENSIONS IN INCHES UNLESS OTHERWISE SPECIFIED	FILE DF/83E	PROJECT REFERENCE 3516B REMAN POWER MODULE				
4	3	2	1	NO	TOLERANCES: X.X ± 0.100 X.XX ± 0.060 X.XXX ± 0.005	THIRD ANGLE PROJECTION	SCALE/SHEET SIZE 1=1/B	DRAWN BY D. ROLING	ENGINEERING STATUS		
					ANGULAR ± 1°		SHEET 2 OF 2	DATE 07/24/2017	PROTO X	PET X	PROD X
TITLE INTERCONNECT HARNESS - ENGINE TO P7/DOGHOUSE									DRAWING NUMBER 83E201B-04		